

**ORDINANCE NO. 2023-3**  
**ORDINANCE VACATING PUBLIC WAY/ALLEY**

WHEREAS, a petition has been filed with the Town of Westport to vacate a certain public way/alley;

WHEREAS, notices have been given to all owners of land which about the property proposed to be vacated and published prior to the hearing on the petition as required by law;

WHEREAS, the Westport Town Council has determined that the vacation of this public way/alley will not hinder the development of the area nor hinder the public's access to a church, school, or other public building.

NOW THEREFORE BE IT ORDAINED by the Town Council of Westport, Indiana that

1. The following public way/alley shall be vacated:

The public way/alley running North to South, East of parcel 16-18-01-110-009.000-014 and West of parcel 16-18-01-110-010.000-014 starting at West Sycamore Street and ending at the alley North of West Race Street that runs East to West of South Williamson Street. (More specifically depicted on Exhibit "A")

This land shall become the property of and shall be assessed for tax purposes to those owners of land adjoining the vacated public way/alley.

These vacations are subject to the right of any public utility which is now using this property for the location and operation of its facilities to continue to do so.

2. This ordinance shall be in full force and effect from and after its passage.

ADOPTED AND PASSED by the Town Council of the Town of Westport, Indiana, this 8<sup>th</sup> day of May, 2023.

Ayes

3


Nays

0

Henry Pray III  
John Dumas  
Joy de Binkley

Attest:

  
Gloria Alumbaugh, Clerk-Treasurer

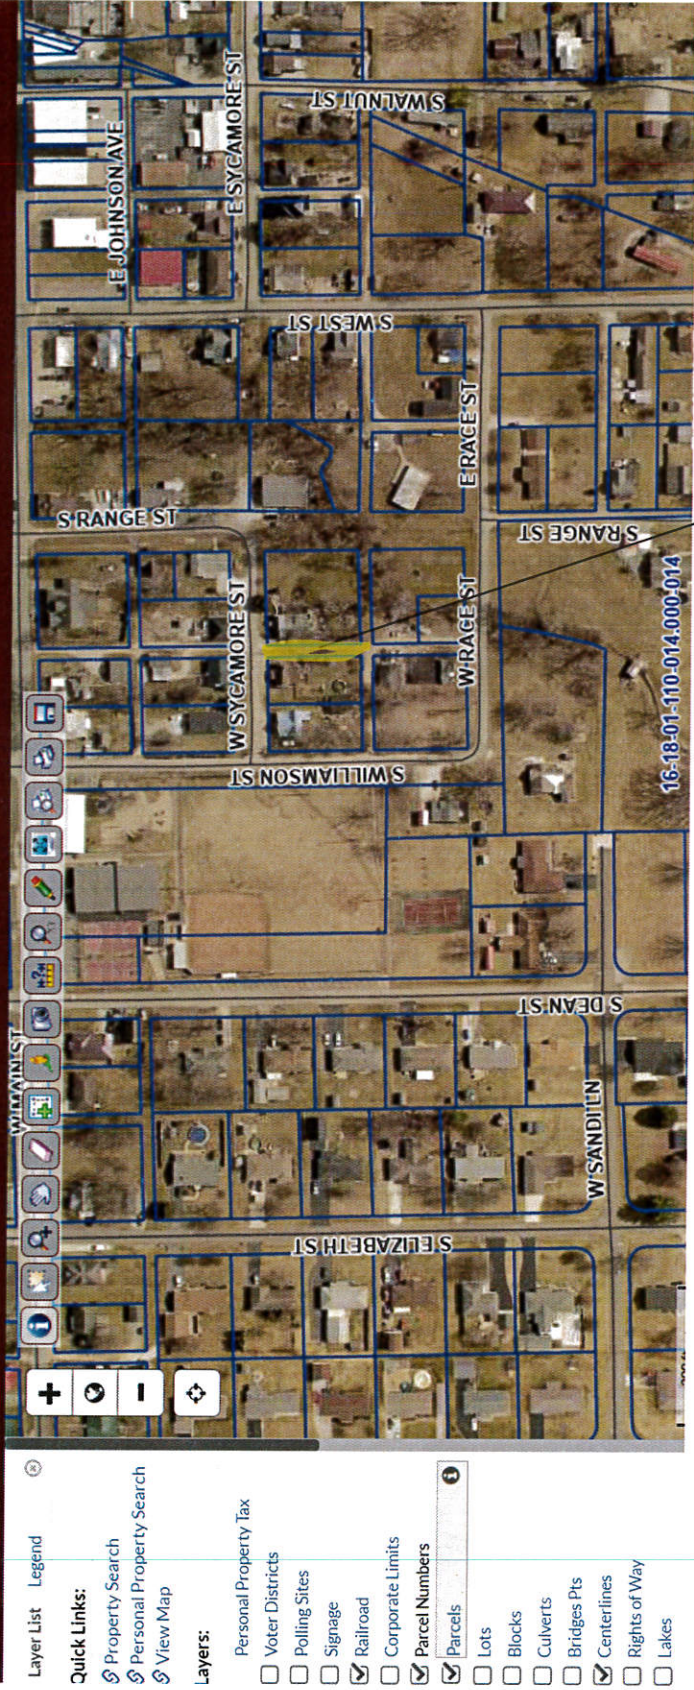

VACATED ALLEY

- Layer List Legend
- Quick Links:
  - Property Search
  - Personal Property Search
  - View Map
- Layers:
  - Personal Property Tax
  - Voter Districts
  - Polling Sites
  - Signage
  - Railroad
  - Corporate Limits
  - Parcel Numbers
  - Parcels
  - Lots
  - Blocks
  - Culverts
  - Bridges Pts
  - Centerlines
  - Rights of Way
  - Lakes